

WEST VIRGINIA
SEPTIC TANK INSPECTION FORM

N Hampshire County Health Department Installation Permit No. ST-14-41-506
Name of Owner Clyde O. Brill Steven Greenwood
Address 304 Prospect Drive, Leesport, VA 22075
Property Address Capon River Road, Capon Bridge

DESCRIPTION & NUMBER OF UNITS SERVED

Type Facility Served house No. Water Closets —
Lot Size 10+ ^{acres} sq. ft. Area suitable for sewage disposal installation — sq. ft.
Source of Water Supply spring house No. Lavatories —
No. Bedrooms 3 No. Showers or Tubs — No. Baths —
No. Garbage Grinders — No. Automatic Washers —

SEPTIC TANK

Material concrete Length — x Width — x Depth — = — cubic feet
Liquid Depth — ft. Liquid Capacity 1000 gal.

Distance to: Dwelling 15' Water Supply 100'+ Nearest Property Line 100'+

SOIL ABSORPTION SYSTEM

Type Drain Line Material plastic Trench Width 36 Inches
Trench Depth 22-26 Inches Total Absorption area in Trench Bottom 900 sq. ft.
Diameter of Drain Line 4 Inches Type Filter Media gravel - 32 tons
No. of Drain Lines 3 Depth Filter Media Under Drain Line 6-8 Inches
Length of Each Line 100, 100, 100, ft. Depth Filter Media Over Drain Line 2 in.
Distance of Disposal Field to: (a) Dwelling 31'
(b) Water Supply 100'+ (c) Nearest Property Line 100'+

An inspection of the septic tank system described herein disclosed that said system (MEETS, DOES NOT MEET) the minimum standards established by the West Virginia State Department of Health.

45-91
Date


[Signature]
Sanitarian

SKETCH OF SYSTEM TO BE DRAWN ON BACK

Note: Copy of this inspection report must be given to owner and the original filed in the Health Department files. PERMANENT RECORD - DO NOT DESTROY.

Yde D. Brill
Leesburg, VA

* Capon Bridge
* River Road
* St. 14-91-506

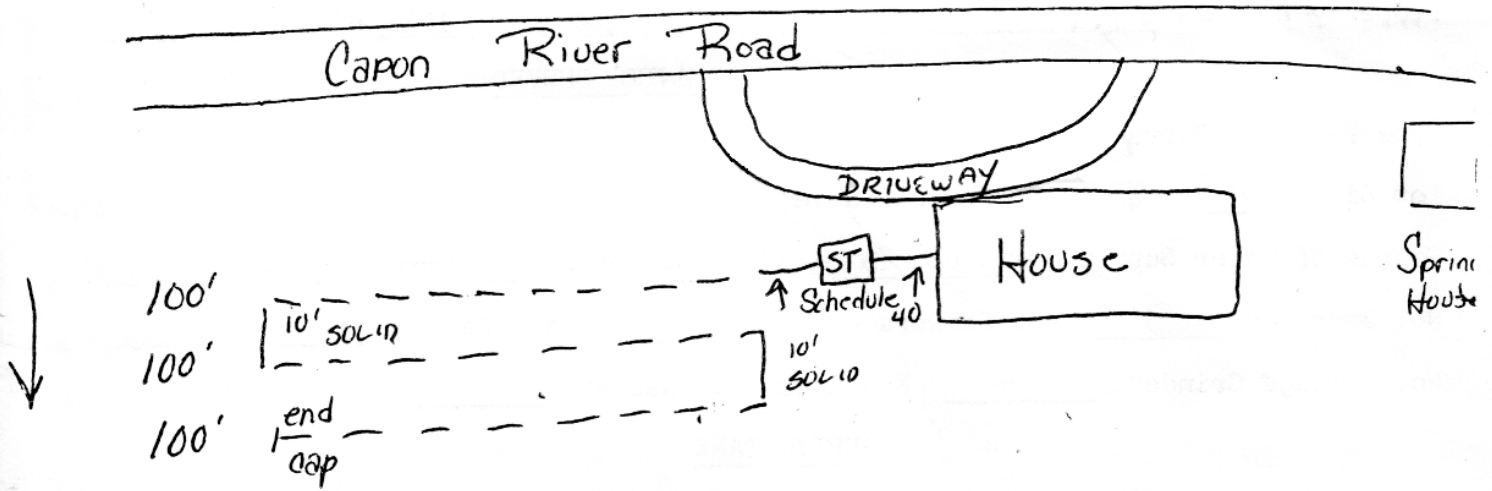

* All lines level to 2 inches

* System Installed March 26, 1991

Installers

Calvin B. Davis
54-83-124